

## GENERAL

## INTERSECTION OPERATION

## SPECIAL NOTES

PROJECT CONTACTS:

MR. RICHARD LINDSAY, ASSISTANT DISTRICT ENGINEER - TRAFFIC  
PHONE: (410) 810-3210  
MR. JEFF AMORIELLA, ASSISTANT DISTRICT ENGINEER - CONSTRUCTION  
PHONE: (410) 810-3270  
MR. TERRY O. WRIGHT, ASSISTANT DISTRICT ENGINEER - MAINTENANCE  
PHONE: (410) 810-3250  
MR. BARRY CLOTHIER, UTILITY ENGINEER  
PHONE: (410) 810-3275  
MR. ED RODENHIZER, SIGNAL SHOP CHIEF  
PHONE: (410) 787-7652  
MR. SONNY BAILY, SIGN SHOP CHIEF  
PHONE: (410) 787-7676  
MR. RICHARD L. DAFF, SR. CHIEF TRAFFIC OPERATIONS DIVISION  
PHONE: (410) 787-7630

A. EQUIPMENT TO BE SUPPLIED BY THE ADMINISTRATION.

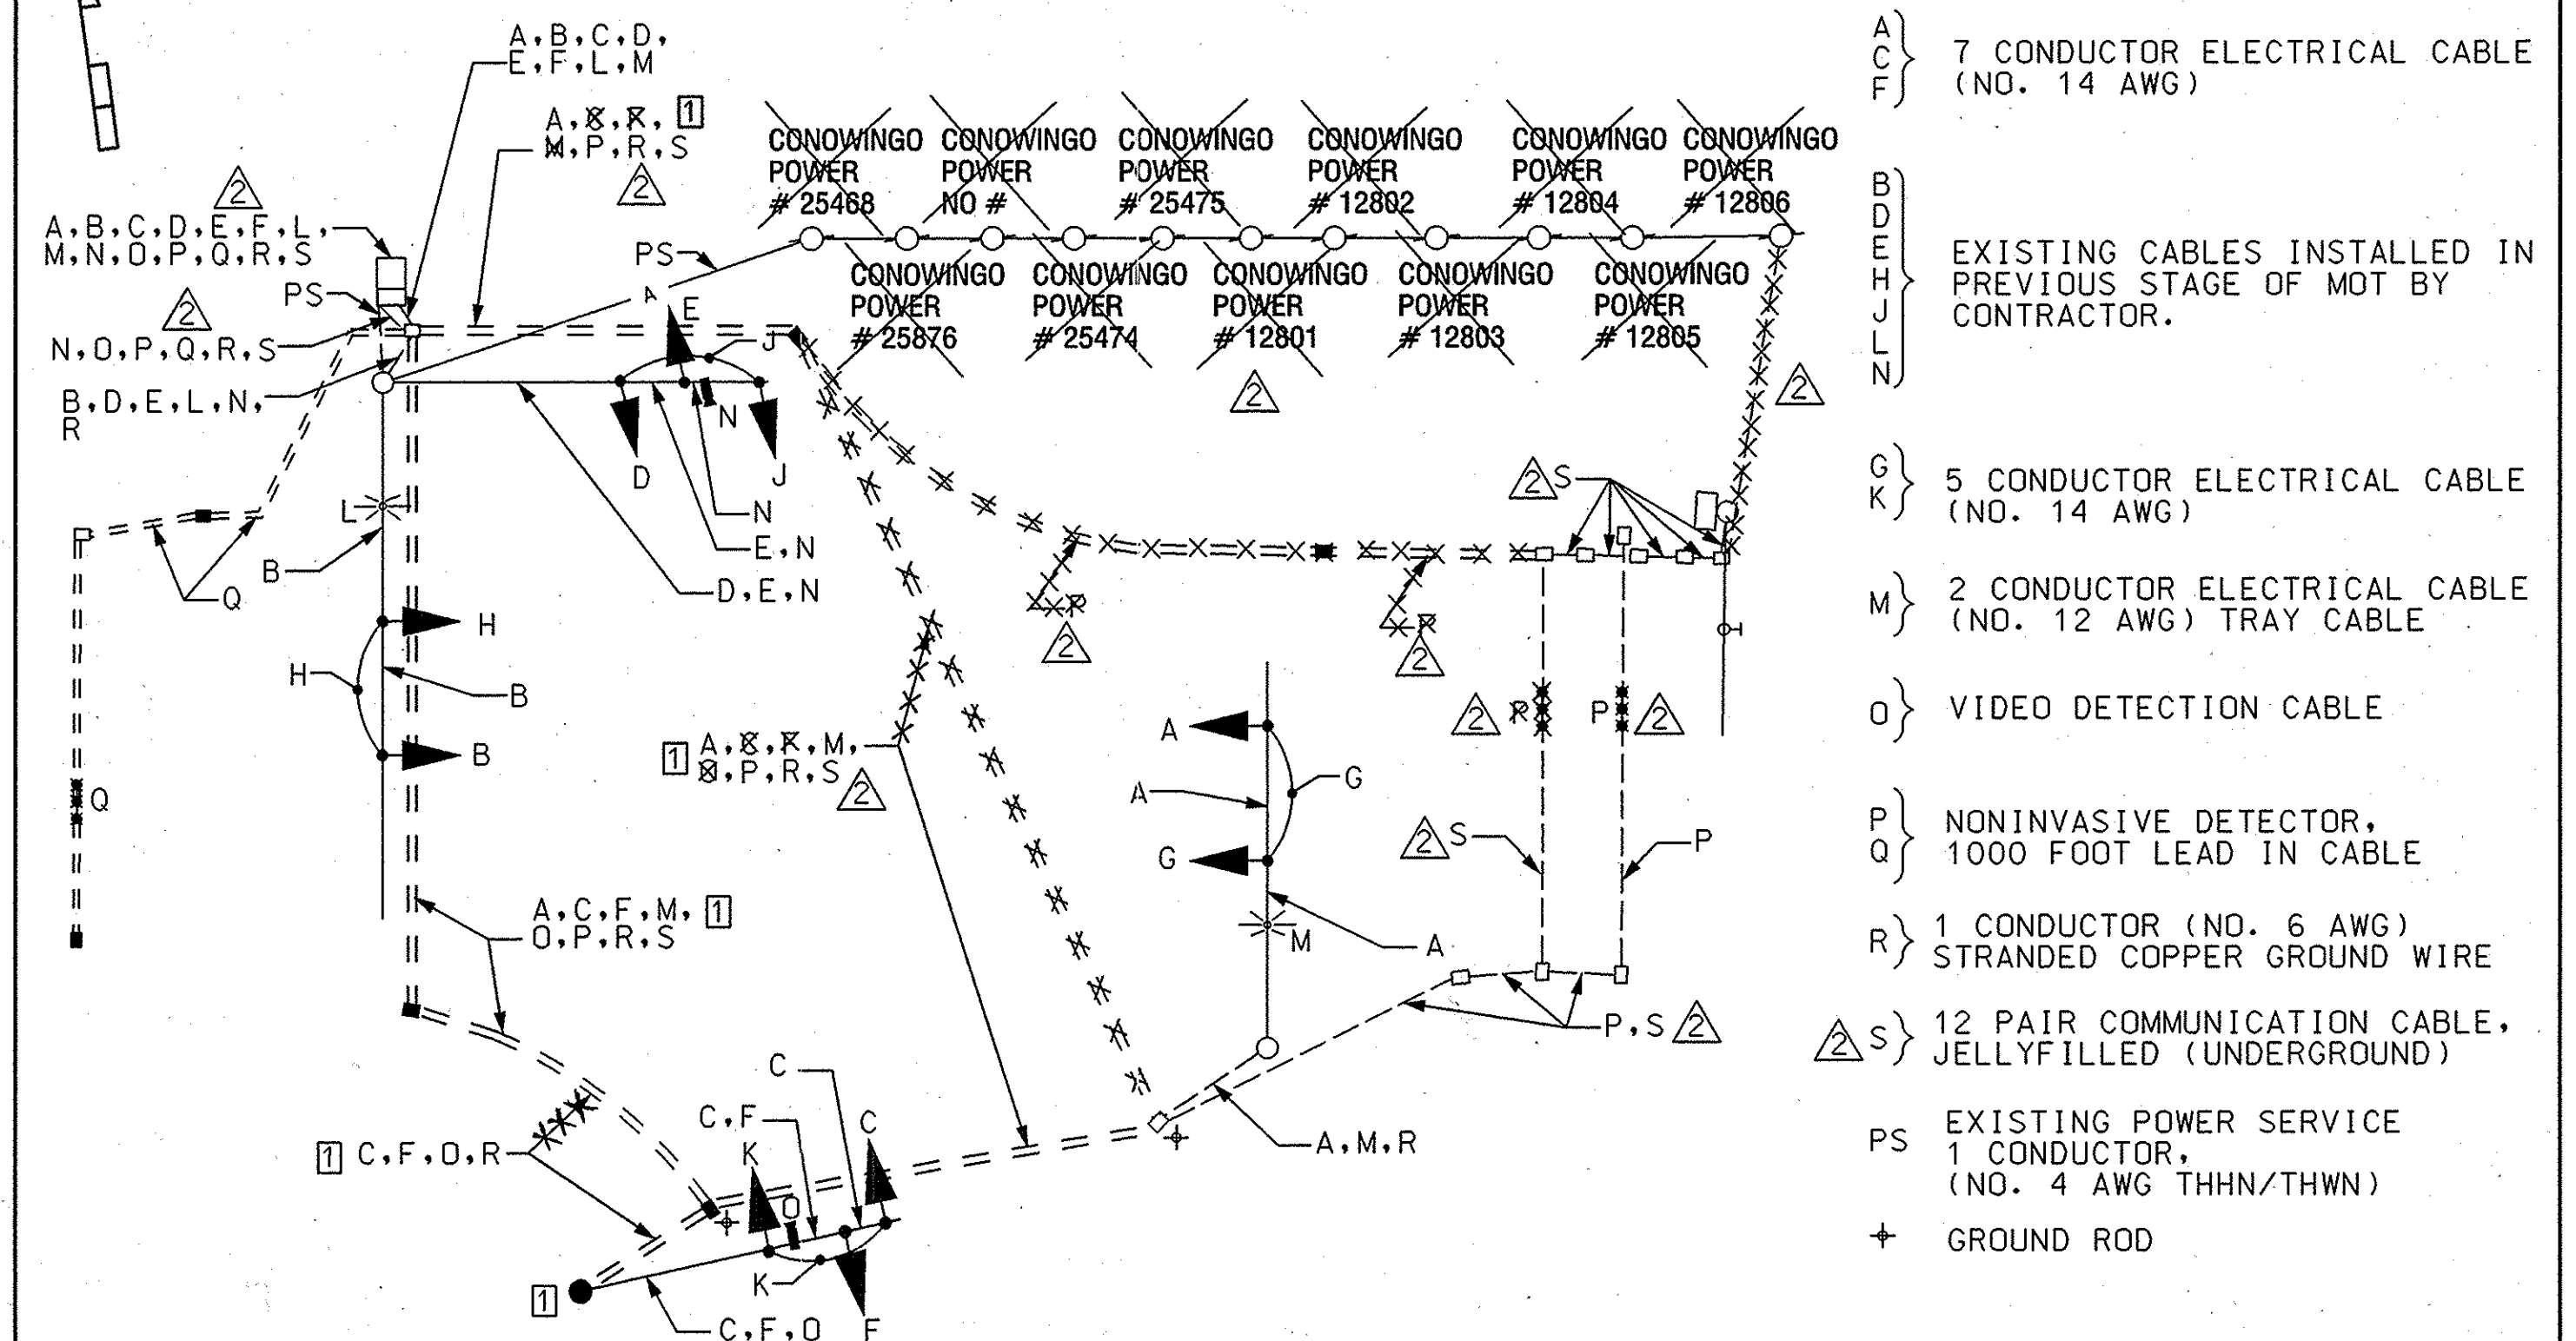
UNITS	QUANTITY
SF	86123
EA	32
EA	2
EA	1
EA	1

CATEGORY CODE NO.	DESCRIPTION
----------------------	-------------

585462	REMOVE OF PERMANENT PAVEMENT LINE MARKINGS - ANY WIDTH	LF	83
585624	24 INCH HEAT APPL. WHITE PERMANENT PREFORMED THERMO. PAVEMENT MARKING	LF	105
800000	REMOVE AND DISPOSE OF EXISTING EQUIPMENT	LS	1
800000	RELOCATE EXISTING OVERHEAD SIGN ON MAST ARM	SF	58
801004	CONCRETE FOR SIGNAL FOUNDATION	CY	3
801106	WOOD SIGN SUPPORTS 4 INCH X 6 INCH	LF	40
802501	NO. 6 AWG STRANDED BARE COPPER GROUND WIRE	LF	270
805115	3 INCH SCHED. 80 PVC CONDUIT- BORED	LF	125
805118	4 INCH SCHED. 80 PVC CONDUIT- BORED	LF	260
805135	3 INCH SCHED. 80 PVC CONDUIT- TRENCHED	LF	670
805140	4 INCH SCHEDULE 80 RIGID PVC CONDUIT - TRENCHED	LF	60
810605	NONINVASIVE DETECTOR, 1000 FOOT LEAD IN CABLE	EA	2
811001	FURNISH AND INSTALL ELECTRICAL HANDHOLE	EA	6
813014	INSTALL GROUND MOUNTED SIGN	SF	36
813015	INSTALL OVERHEAD SIGN	SF	66
816005	CONTROL CABLE, 250 FOOT, VIDEO DETECTION CAMERA	EA	1
816010	CONTROL CABLE, 500 FOOT, VIDEO DETECTION CAMERA	EA	1
818030	STEEL POLE WITH A SINGLE 38 FOOT MAST ARM	EA	1
822002	12-PAIR COMMUNICATION CABLE, JELLYFILLED (UNDERGROUND)	LF	1530
837001	GROUND ROD - 3/4 INCH DIA. X 10 FOOT LENGTH	EA	2
860265	RELOCATE EXISTING SIGNAL HEAD	EA	12
860270	8 INCH VEHICULAR SIGNAL HEAD SECTION	EA	3
860272	12 INCH VEHICULAR TRAFFIC SIGNAL HEAD SECTION	EA	8
861107	ELECTRICAL CABLE - 5 CONDUCTOR (NO. 14 AWG)	LF	80
861108	ELECTRICAL CABLE - 7 CONDUCTOR (NO. 14 AWG)	LF	765
861116	ELECTRICAL CABLE - 2 CONDUCTOR (NO. 12 AWG)	LF	305

UNITS	QUANTITY
LF	83
LF	105
LS	1
SF	58
CY	3 $\frac{1}{2}$
LF	40 $\frac{1}{2}$
LF	<del>270</del> 435 $\frac{1}{2}$
LF	<del>125</del> 55
LF	260
LF	<del>670</del> 357
LF	60 $\frac{1}{2}$
EA	2
EA	<del>6</del> 4 $\frac{1}{2}$
SF	36 $\frac{1}{2}$
SF	<del>46</del> 76 $\frac{1}{2}$
EA	<del>1</del> 2 $\frac{1}{2}$
EA	1
EA	$\frac{1}{2}$ $\frac{1}{2}$
LF	1530 $\frac{1}{2}$
EA	<del>1</del> 2 $\frac{1}{2}$
EA	12
EA	3 $\frac{1}{2}$
EA	8 $\frac{1}{2}$
LF	80
LF	<del>765</del> 785 $\frac{1}{2}$
LF	<del>305</del> 360 $\frac{1}{2}$

KEY

[illegible]

## ULTIMATE

# SHA

TRAFFIC ENGINEERING DESIGN DIVISION  
GENERAL INFORMATION PLAN

MD 273 (TELEGRAPH ROAD) AT  
MD 213 (LEWISVILLE /SINGERLY ROAD)

① REDLINE REVISION No.1  
② ADDENDUM No. 2



**SABRA, WANG & ASSOCIATES, INC.**  
1504 JOH AVENUE  
SUITE 160  
BALTIMORE, MD 21227  
(410) 737-6564  
[WWW.SABRA-WANG.COM](http://WWW.SABRA-WANG.COM)

DRAWN BY: <u>S. SMITH</u>	F.A.P. NO. <u>.</u>	TS NO. <u>TS-838 E</u>	SHEET NO.  28 OF 28
CHECKED BY: <u>S. RENZI</u>	S.H.A. NO. <u>CE445176</u>	T.I.M.S. NO. <u>F246</u>	
SCALE: <u>1" = 20'</u>	COUNTY: <u>CECIL</u>		
DATE: <u>AUGUST, 2004</u>	LOG MILE: <u>07021325.94</u>		